


THE CITY OF LOS ANGELES OR ITS OFFICERS OR AGENTS SHALL NOT BE RESPONSIBLE FOR THE ACCURACY OR COMPLETENESS OF ELECTRONIC COPIES OF THIS PLAN SHEET.

DESIGN STAGE (DESIGN STAGE ONLY)

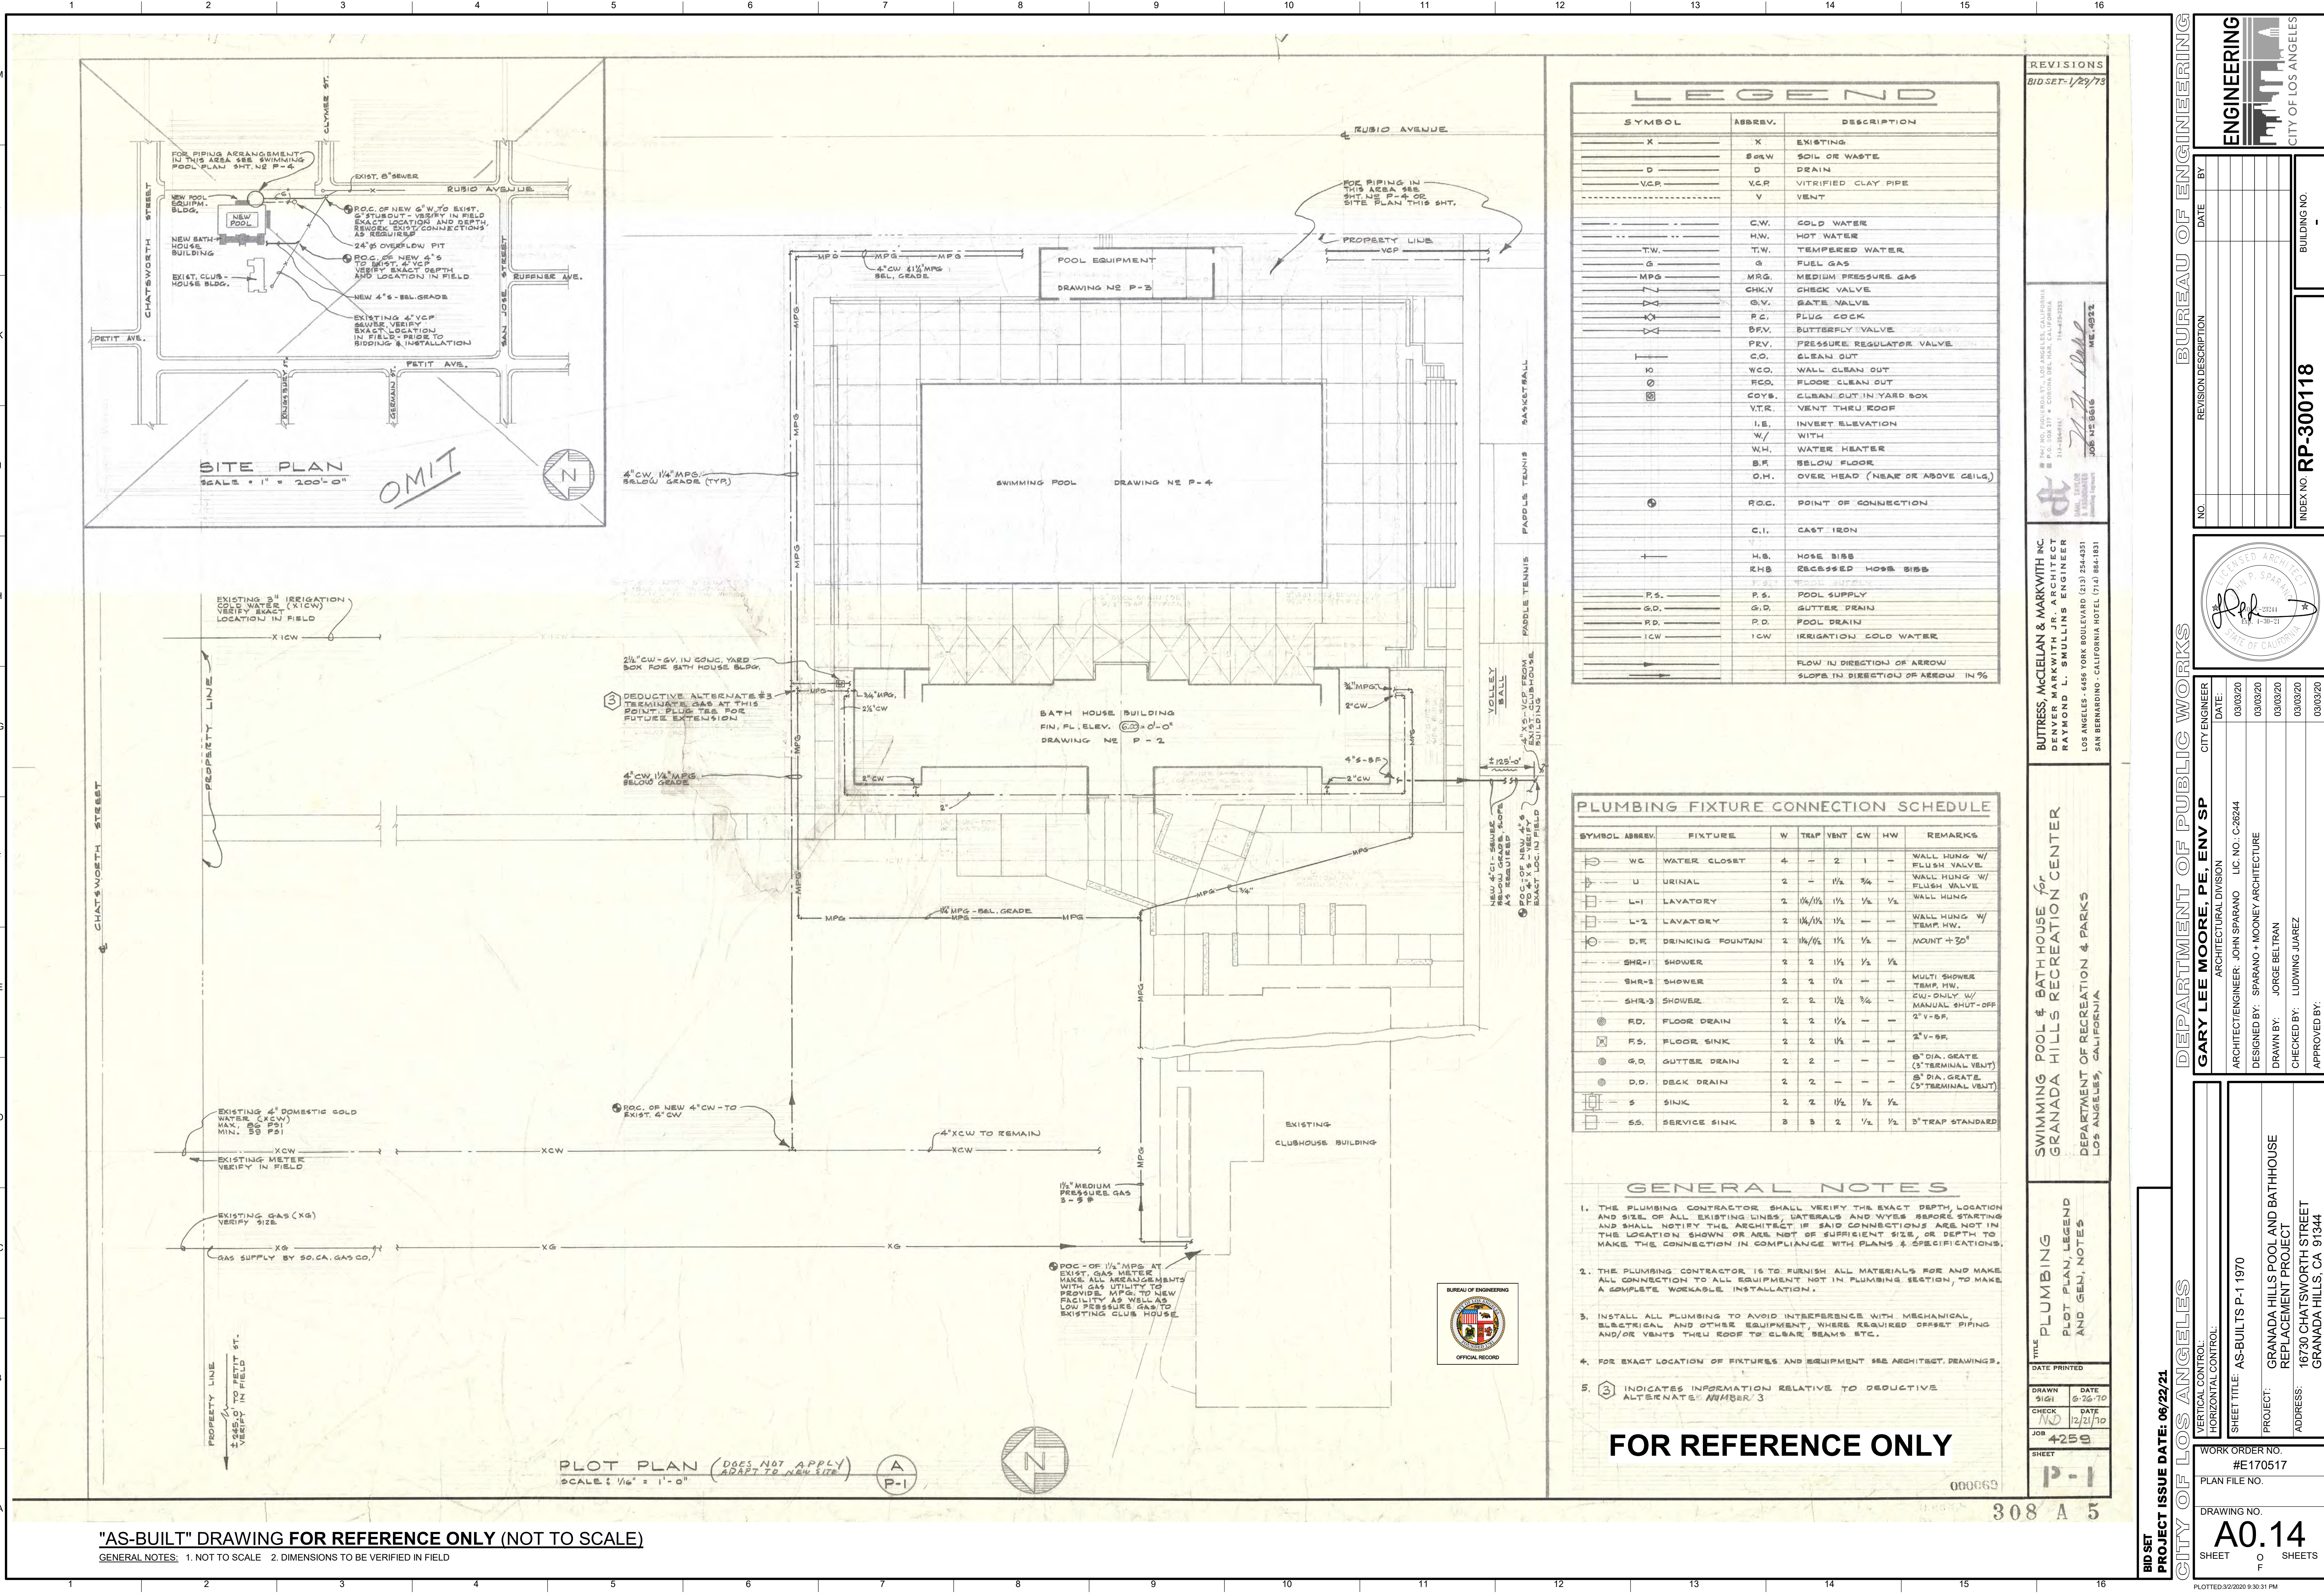

"AS-BUILT" DRAWING FOR REFERENCE ONLY (NOT TO SCALE)
GENERAL NOTES: 1. NOT TO SCALE 2. DIMENSIONS TO BE VERIFIED IN FIELD

REVISIONS
BID SET - 1/29/75

BUTRESS, MCLELLAN & MARKWITH INC.
RAYMOND L. SMULLINS, ENGINEER
LOS ANGELES - 6455 YORK BOULEVARD (213) 254-4351
SAN BERNARDINO - CALIFORNIA HOTEL (714) 884-1831

ENGINEERING
CITY OF LOS ANGELES

INDEX NO **RP-300118**

DEPARTMENT OF PUBLIC WORKS

GARY LEE MOORE, PE, ENV SP
ARCHITECTURAL DIVISION

ARCHITECT/ENGINEER: JOHN SPARANO LIC. NO. C-48244
DESIGNED BY: SPARANO • MOONEY ARCHITECTURE
DRAWN BY: JORGE BELTRAN
CHECKED BY: LUDWIG JUAREZ
APPROVED BY:

CITY OF LOS ANGELES

SWIMMING POOL & BATH HOUSE
GRANADA HILLS RECREATION CENTER
DEPARTMENT OF RECREATION & PARKS
LOS ANGELES, CALIFORNIA

PLUMBING
PLOT PLAN, LEGEND
AND GEN. NOTES

DATE PRINTED: 8-26-70
DRAWN: 9/6/70
CHECK: 12/21/70
JOB: 4259

DATE: 8-26-70
DATE: 12/21/70
JOB: 4259

FOR REFERENCE ONLY

000669
308 A 5

PROJECT ISSUE DATE: 06/22/21

A0.14

SHEET 0 OF SHEETS

WORK ORDER NO. #E170517
PLAN FILE NO.
DRAWING NO.