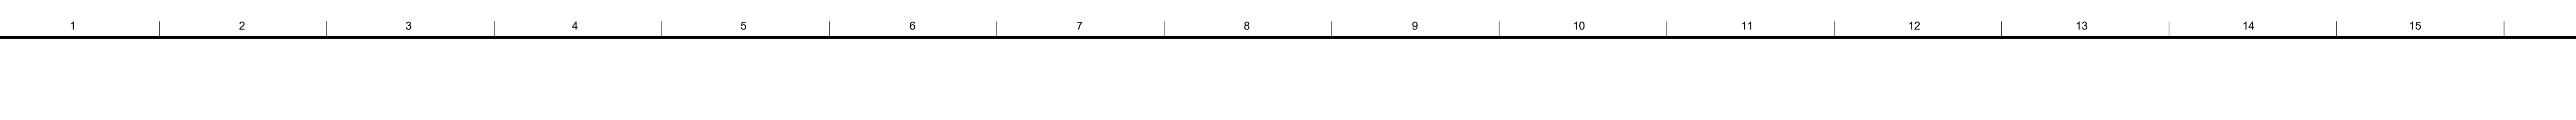


REVISION DATES  
(DESIGN STAGE ONLY)

A horizontal number line with arrows at both ends. It is labeled with the numbers 12, 13, and 14. There are tick marks at every integer from 12 to 14.

GENERAL NOTES: 1. NOT TO SCALE 2. DIMENSIONS TO BE VERIFIED IN FIELD

100

GENERAL MANAGER	DESIGNED/DATE	REVISIONS	DATE	BY
DIRECTOR OF PLANNING AND DEVELOPMENT	R.K. 10-9-98	2 SITE POWER SYSTEM / BULLETIN #1	10/28/98	
	QSMW/DATE			
	A.M. 10-9-98			
CONTRACTOR ADMINISTRATOR	CHECKED/DATE			
	R.K. 10-9-98			

	REVISIONS	DATE	BY
3	2 SITE POWER SYSTEM / BULLETIN #1	10/28/98	
3			
3			



GENERAL MANAGER	
DIRECTOR OF PLANNING AND DEVELOPMENT	
CONTRACTOR ADMINISTRATOR	

SHEET TITLE  
SITE ELECTRICAL PLAN  
PROJECT  
GRANADA HILLS RECREATION CENTER  
FACILITY ADDRESS  
16730 CHATSWORTH STREET, GRANADA HILLS, CA 91344

Downloaded from <https://www.cambridge.org/core>. University of Cambridge, on 02 Jun 2018 at 10:00:00, subject to the Cambridge Core terms of use, available at <https://www.cambridge.org/core/terms>. <https://doi.org/10.1017/S0022278X18000500>


DEPARTMENT OF PUBLIC WORKS BUREAU OF ENGINEERING

DRAWING NO.  
**A0.1**  
SHEET OF 5

VERTICAL CONTROL: HORIZONTAL CONTROL:		SHEET TITLE: AS-BUILT S E 12 1998	
PROJECT: GRANADA HILLS POOL AND BATHHOUSE REPLACEMENT PROJECT		ADDRESS: 16730 CHATSWORTH STREET	
WORK ORDER NO. #E170517		PLAN FILE NO.:	
GARY LEE MOORE, PE, ENV SP		CITY ENGINEER	
ARCHITECTURAL DIVISION		DATE:	
ARCHITECT/ENGINEER: JOHN SPARANO LIC. NO.: C-26244		03/03/20	
DESIGNED BY: SPARANO + MOONEY ARCHITECTURE		03/03/20	
DRAWN BY: JORGE BELTRAN		03/03/20	
CHECKED BY: LUDWIG JUAREZ		03/03/20	
SEAL: 		CITY OF LOS ANGELES	
INDEX NO. <b>DB 300118</b>		BUILDING NO.	
REVISION DESCRIPTION		DATE	
NO.		BY	
ENGINEERING			

BUREAU OF ENGINEERING

NO.	REVISION DESCRIPTION	DATE	BY

DATE:	03/03/20
	
<h1>ENGINEERING</h1>	

03/03/20	03/03/20
----------	----------

[illegible]

03/03/20		INDEX NO. <b>RP-300118</b>	BUILDING NO.
----------	---	----------------------------	--------------

<b>GARY LEE MOORE, PE, ENV SP</b>	<b>CITY ENGINEER</b>
<b>ARCHITECTURAL DIVISION</b>	<b>DATE:</b>
ARCHITECT/ENGINEER: JOHN SPARANO LIC. NO.: C-26244	03/03/20
DESIGNED BY: SPARANO • MOONEY ARCHITECTURE	03/03/20
DRAWN BY: JORGE BELTRAN	03/03/20
CHECKED BY: LUDWIG JUAREZ	03/03/20

[illegible][illegible]