


REVISION DATES
(DESIGN STAGE ONLY)

"AS-BUILT" DRAWING FOR REFERENCE ONLY (NOT TO SCALE)
GENERAL NOTES: 1. NOT TO SCALE 2. DIMENSIONS TO BE VERIFIED IN FIELD

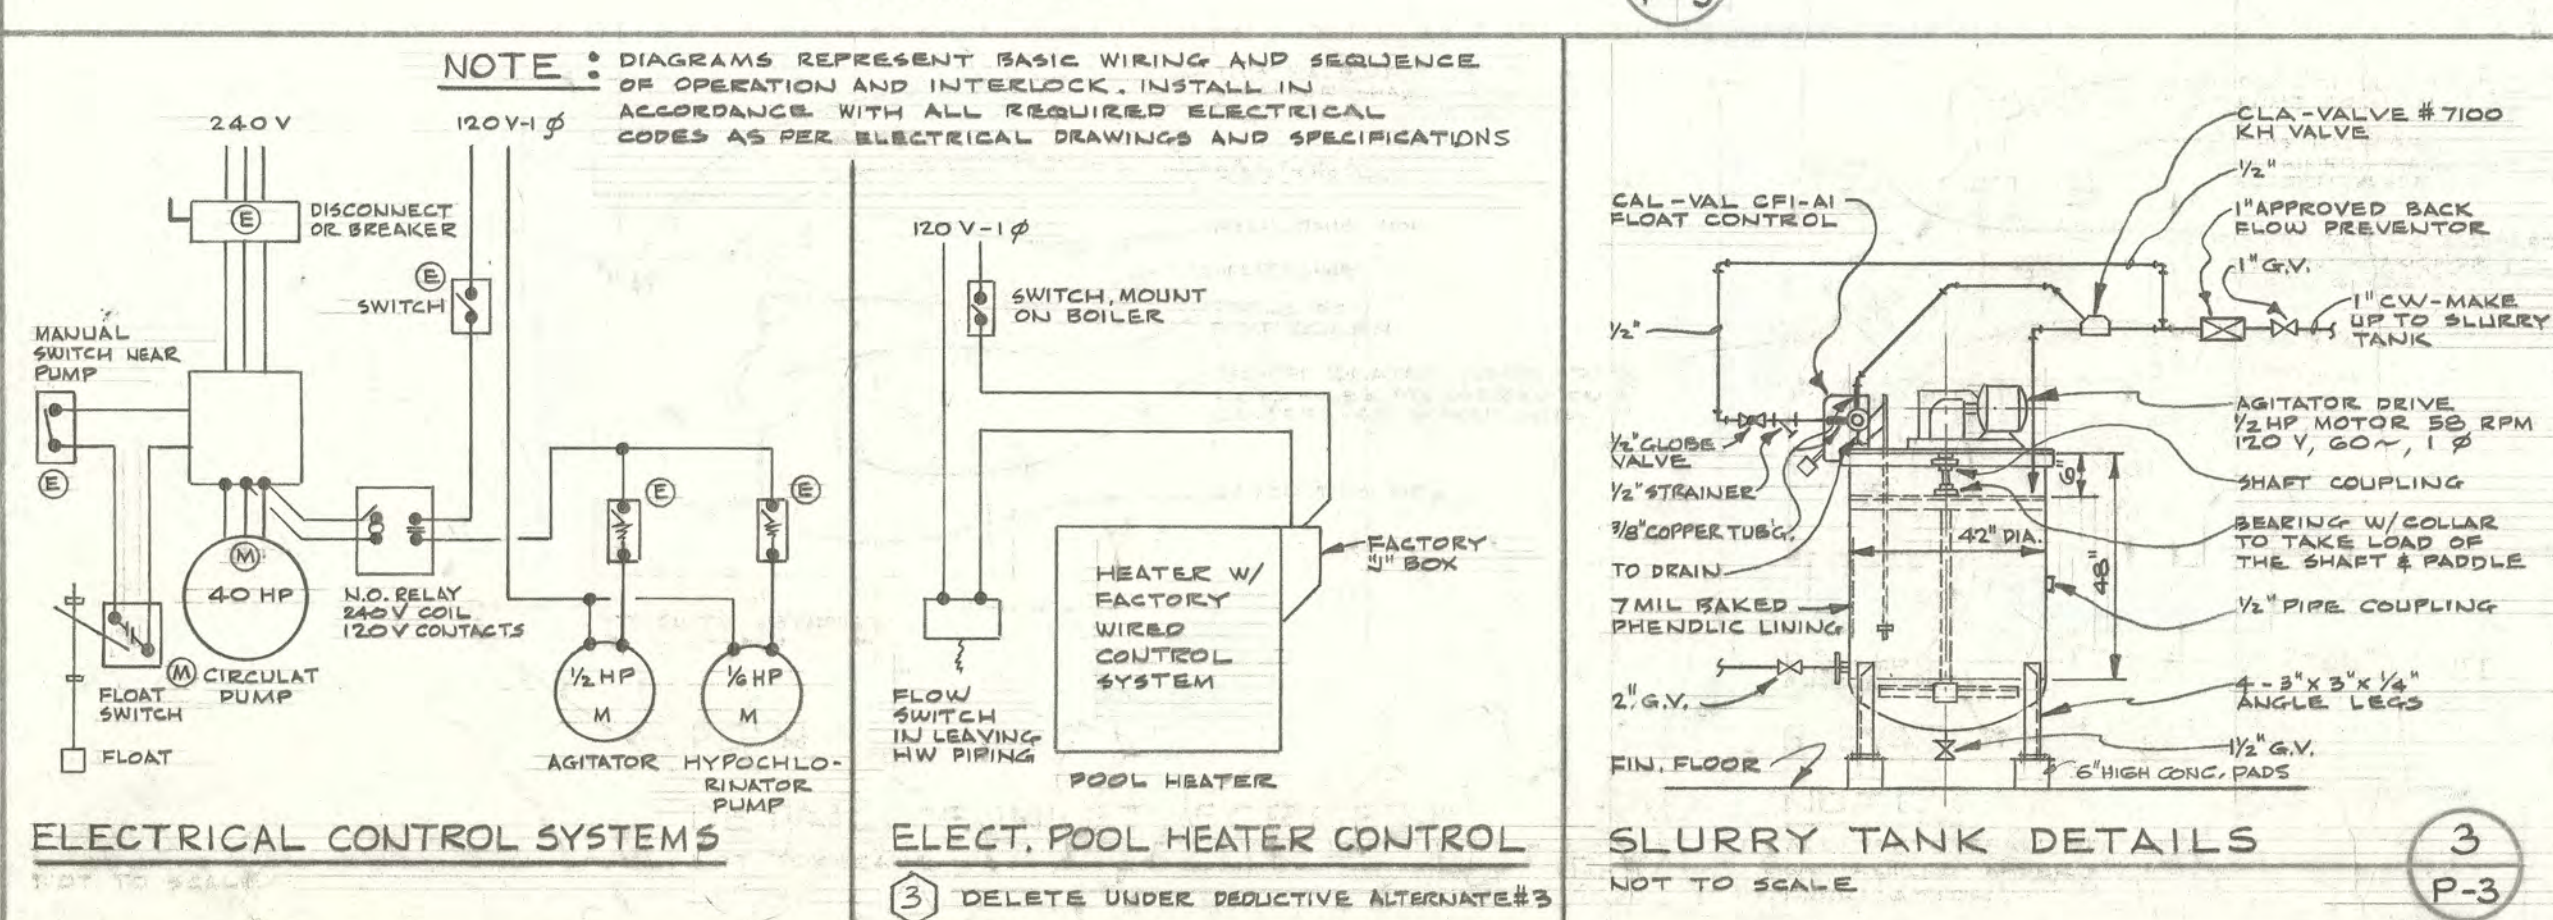

<div style="border: 1px solid black; padding: 2px; margin-bottom: 5px;"> REVISIONS BLDG. DEPT-1/4/73 810 SET-1/29/73 </div>	
<div style="border: 1px solid black; padding: 5px; margin-bottom: 5px;"> <p>7440 NO. HYDEBOAT ST., LOS ANGELES, CALIF. 90044 310-2564161 310-2564161</p> </div> <div style="border: 1px solid black; padding: 5px; margin-bottom: 5px;"> <p>JOE N2 8516 ME-4312</p> </div>	<div style="border: 1px solid black; padding: 5px; margin-bottom: 5px;"> <p>7440 NO. HYDEBOAT ST., LOS ANGELES, CALIF. 90044 310-2564161 310-2564161</p> </div> <div style="border: 1px solid black; padding: 5px; margin-bottom: 5px;"> <p>JOE N2 8516 ME-4312</p> </div>
<div style="border: 1px solid black; padding: 5px; margin-bottom: 5px;"> <p>BUTTRISS, MCCELLAN & MARKWITH INC. DENVER MARKWITH JR. ARCHITECT RAYMOND L. SMULLINS ENGINEER LOS ANGELES - 6456 YORK BOULEVARD (313) 284-4351 SAN BERNARDINO - CALIFORNIA HOTEL (714) 884-1831</p> </div>	
<div style="border: 1px solid black; padding: 5px; margin-bottom: 5px;"> <p>SWIMMING POOL & BATH HOUSE for GRANADA HILLS RECREATION CENTER DEPARTMENT OF RECREATION & PARKS LOS ANGELES, CALIFORNIA</p> </div>	
<div style="border: 1px solid black; padding: 5px; margin-bottom: 5px;"> <p>PLUMBING FILTER BUILDING PLAN & DETAILS</p> </div>	
<div style="border: 1px solid black; padding: 5px; margin-bottom: 5px;"> <p>TITLE DATE PRINTED</p> </div>	
<div style="border: 1px solid black; padding: 5px; margin-bottom: 5px;"> <p>DRAWN 5/61</p> </div> <div style="border: 1px solid black; padding: 5px; margin-bottom: 5px;"> <p>CHECK 16</p> </div> <div style="border: 1px solid black; padding: 5px; margin-bottom: 5px;"> <p>JOB 4259</p> </div>	<div style="border: 1px solid black; padding: 5px; margin-bottom: 5px;"> <p>DATE 6-26-70</p> </div> <div style="border: 1px solid black; padding: 5px; margin-bottom: 5px;"> <p>DATE 12/21/70</p> </div>
<div style="border: 1px solid black; padding: 5px; margin-bottom: 5px;"> <p>SHEET P-3</p> </div>	

SUE DATE: 06/22/21

CITY OF LOS ANGELES

DEPARTMENT OF PUBLIC WORKS

GARY LEE MOORE, PE, ENV SP

VERTICAL CONTROL:
HORIZONTAL CONTROL:

SHEET TITLE: AS-BUILT P-3 1970

PROJECT: GRANADA HILLS POOL AND BATHHOUSE REPLACEMENT PROJECT

ADDRESS: 16730 CHATSWORTH STREET
GRANADA HILLS, CA 91344

WORK ORDER NO. #170517

PLAN FILE NO.

BUREAU OF ENGINEERING

ENGINEER

CITY OF LOS ANGELES

NO.

REVISION DESCRIPTION

DATE

BY

INDEX NO. **RP-300118**

BUILDING NO. -

STATE OF CALIFORNIA

REGISTERED ARCHITECT

JOHN P. SPARANO

1-30-21

1-30-21

CITY ENGINEER

DATE:

ARCHITECT/ENGINEER: JOHN SPARANO **LIC. NO.:** C-26244

DESIGNED BY: SPARANO + MOONEY ARCHITECTURE

DRAWN BY: JORGE BELTRAN

CHECKED BY: LUDWING JUAREZ

APPROVED BY:

FOR REFERENCE ONLY

000067

308-A-5

DRAWING NO.
A0.15
SHEET OF SHEET

F