
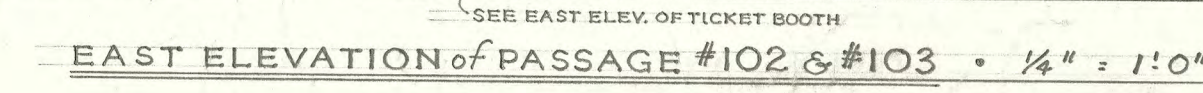
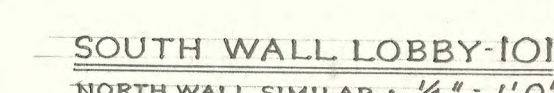
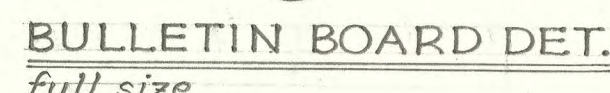
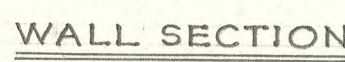
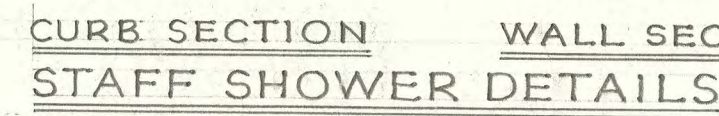
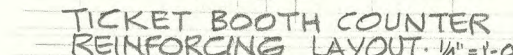
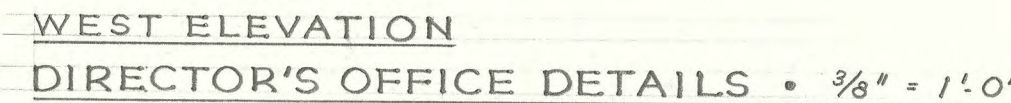
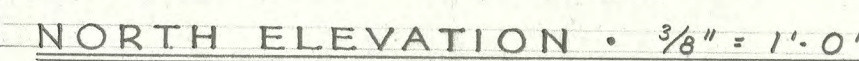
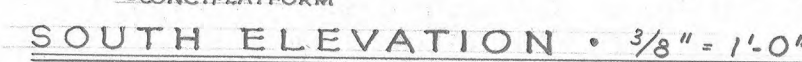
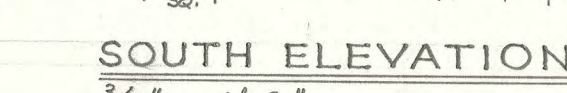
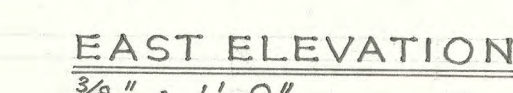
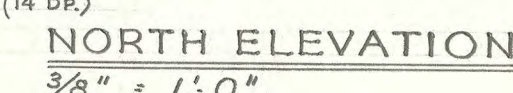
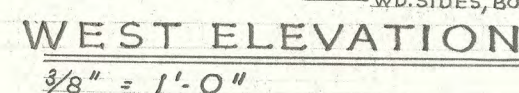
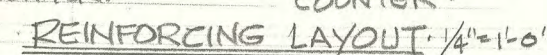
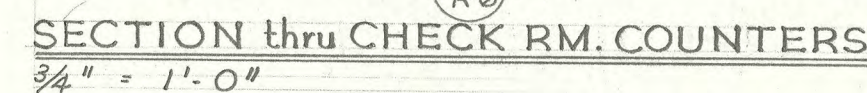
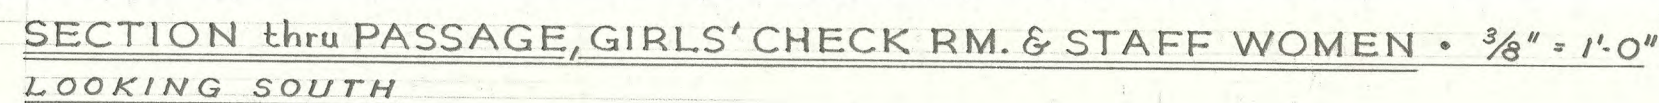


GENERAL NOTES: 1. NOT TO SCALE 2. DIMENSIONS TO BE VERIFIED IN FIELD

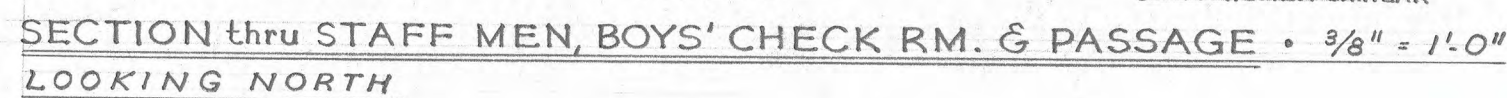

BUTTRISS, MCCLELLAN & MARKWITH INC.
DENVER MARKWITH JR. ARCHITECT
RAYMOND L. SMULLINS ENGINEER
6456 YORK BOULEVARD
LOS ANGELES 42 CLINTON 4-4351

INTERIOR DETAILS:
CENTRAL AREA

1

90% CONSTRUCTION DOCUMENTS
PROJECT ISSUE DATE: 1/11/19

CITY OF LOS ANGELES

VERTICAL CONTROL:	
HORIZONTAL CONTROL:	
SHEET TITLE:	AS-BUILT A-6
PROJECT:	GRANADA HILLS POOL AND BATHHOUSE REPLACEMENT PROJECT
ADDRESS:	16730 CHATSWORTH STREET CANAAN, CA 95009

WORK ORDER NO.
#E170517


PLAN FILE NO.
#308

DRAWING NO.
A0.06

SHEET OF SHEETS

DEPARTMENT OF PUBLIC WORKS

GARY LEE MOORE, PE, ENV SP
ARCHITECTURAL DIVISION
ARCHITECT/ENGINEER: JOHN SPARANO LIC. NO.: LICENSE
DESIGNED BY: Designer
DRAWN BY: Author
CHECKED BY: Checker
APPROVED BY: Approver

[illegible]The logo for the City of Los Angeles Engineering department. It features the word "ENGINEERING" in a large, bold, sans-serif font, oriented vertically. To the right of the text is a stylized graphic of the Los Angeles skyline, including the US Bank Tower. Below the skyline graphic, the words "CITY OF LOS ANGELES" are written in a smaller, sans-serif font. The entire logo is enclosed in a thin black rectangular border.