


FILE PATH: B:\360\Granada Hills Pool Renovation\A_Granada-Hills_2017.nt
SHEET ISSUE DATE: 10/07/18

THE CITY OF LOS ANGELES OR ITS OFFICERS OR AGENTS SHALL NOT BE RESPONSIBLE FOR THE ACCURACY OR COMPLETENESS OF ELECTRONIC COPIES OF THIS PLAN SHEET.

DESIGN STAGES
(DESIGN STAGE ONLY)

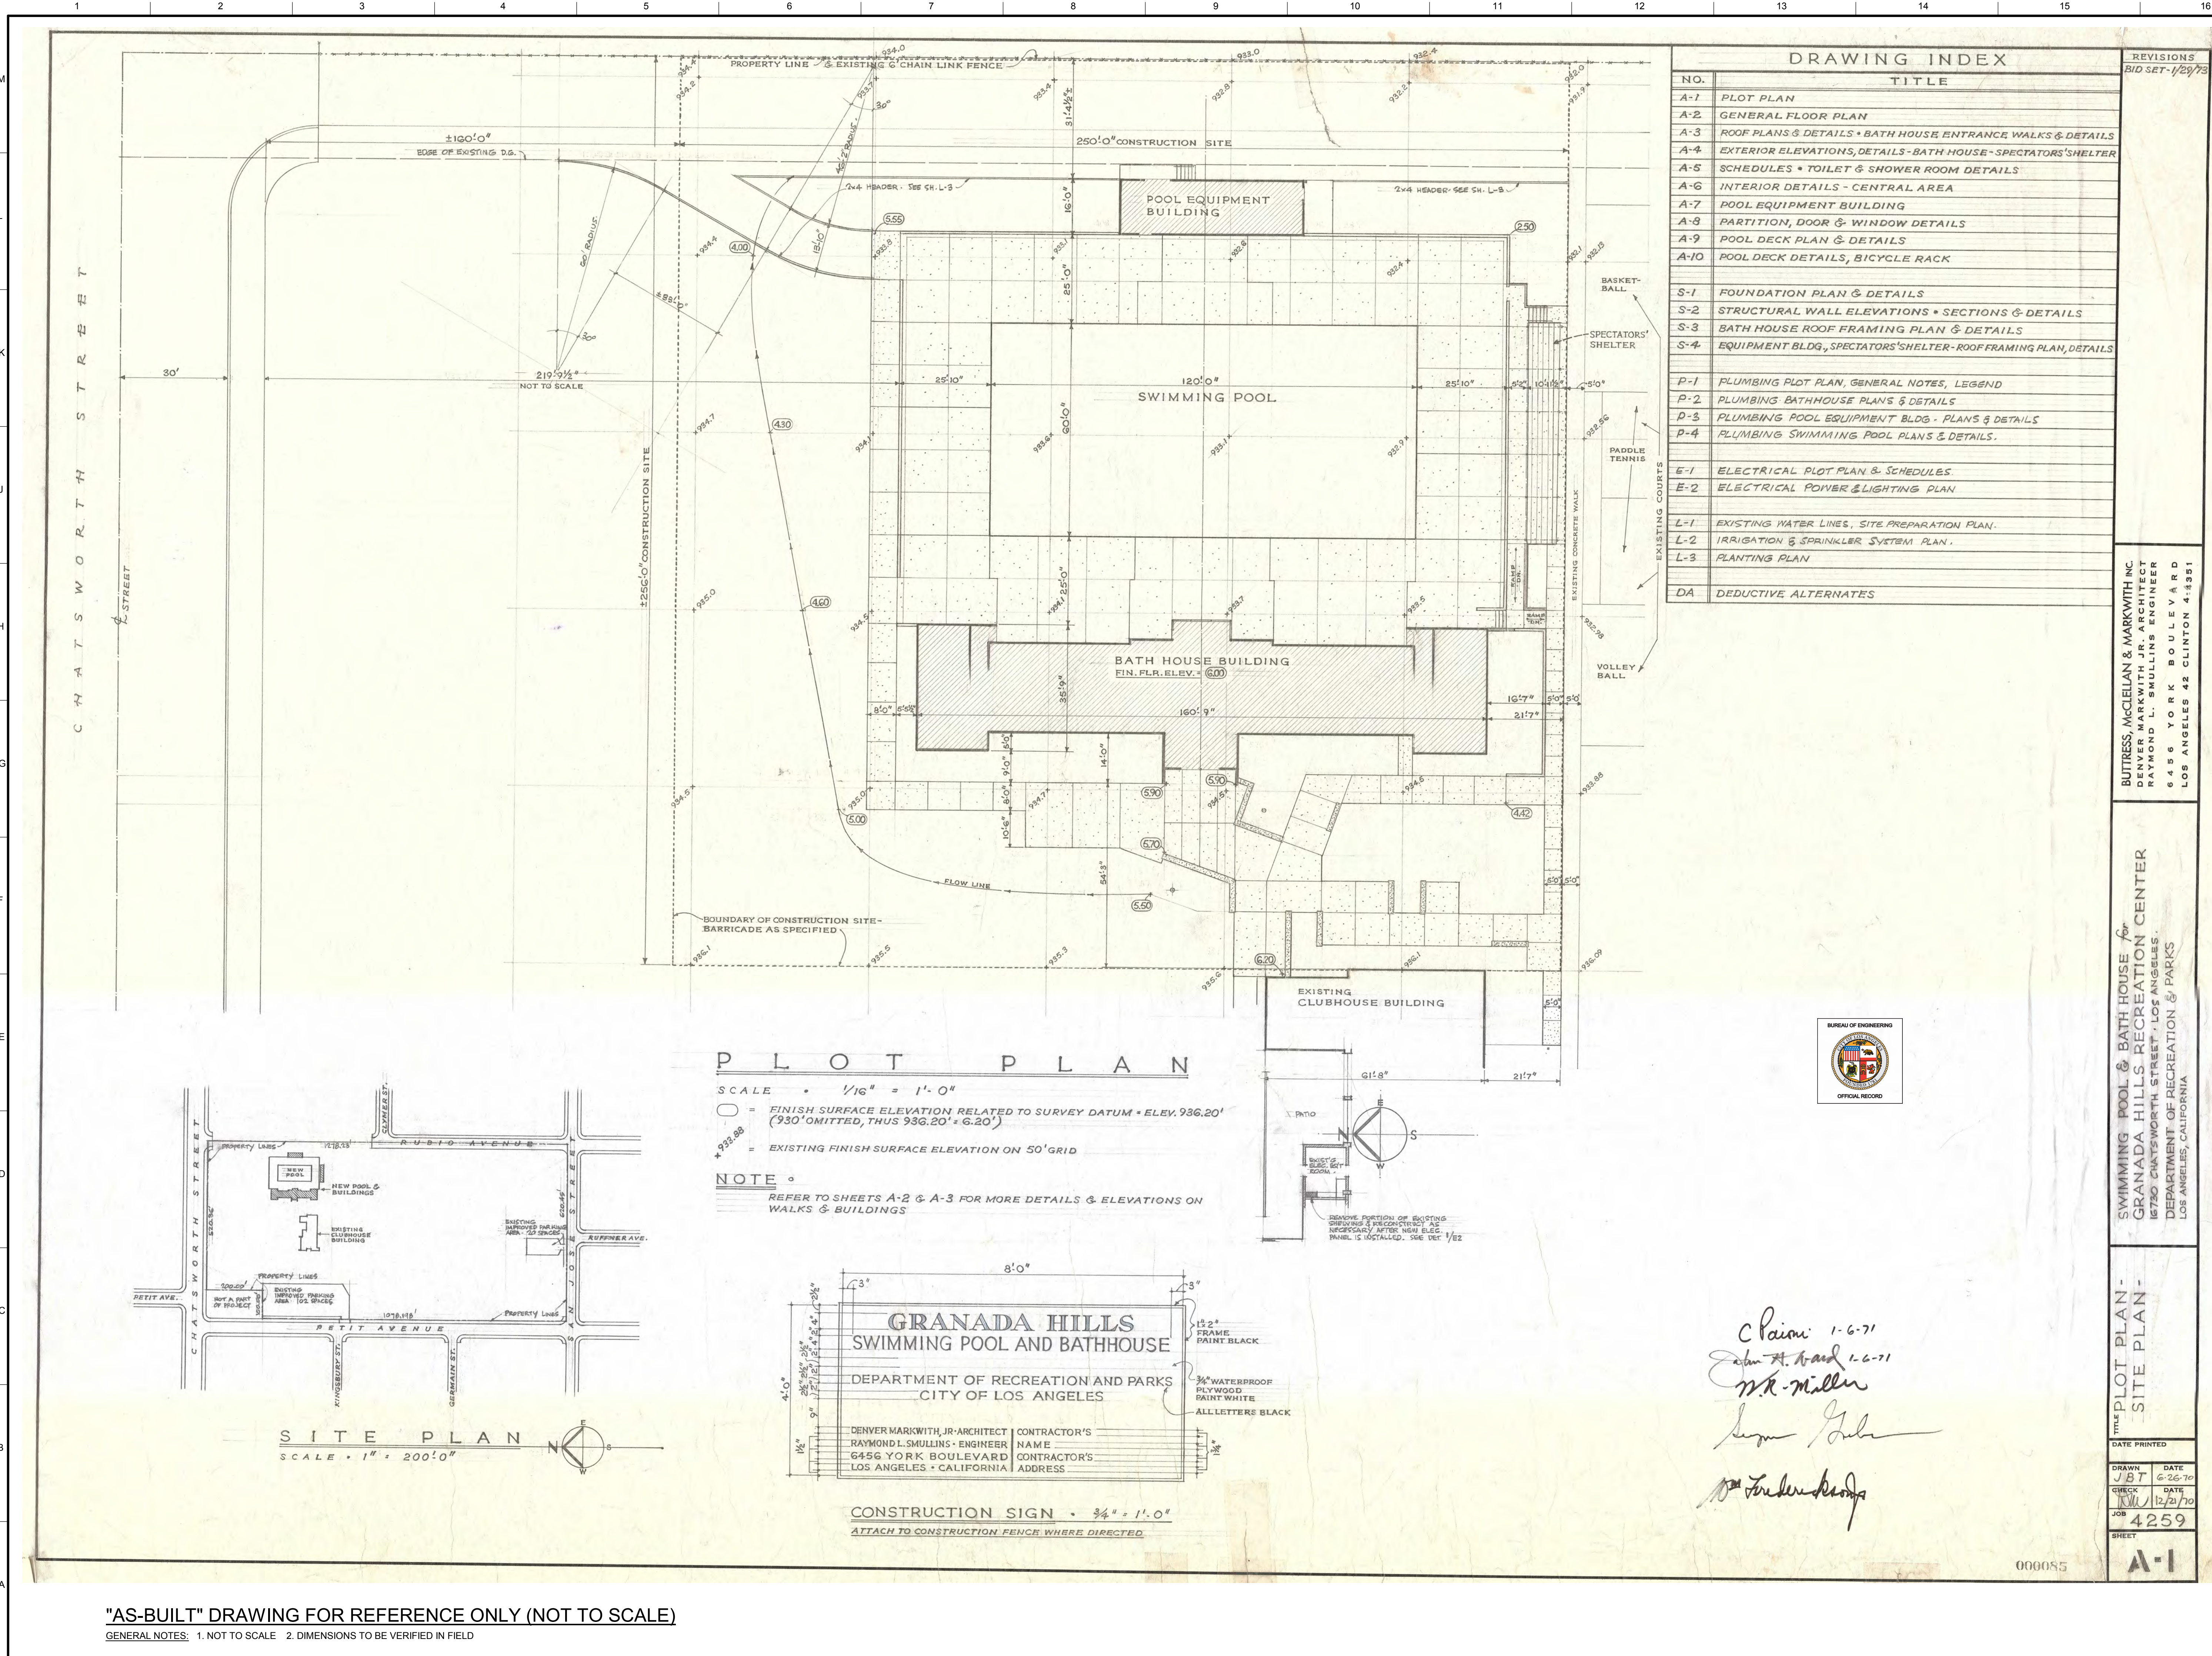

"AS-BUILT" DRAWING FOR REFERENCE ONLY (NOT TO SCALE)
GENERAL NOTES: 1. NOT TO SCALE 2. DIMENSIONS TO BE VERIFIED IN FIELD

PLOT PLAN

SCALE = 1/16" = 1'-0"
O = FINISH SURFACE ELEVATION RELATED TO SURVEY DATUM = ELEV. 936.20'
(930' OMITTED, THUS 936.20' = 6.20')
X 932.88 = EXISTING FINISH SURFACE ELEVATION ON 50' GRID


NOTE:
REFER TO SHEETS A-2 & A-3 FOR MORE DETAILS & ELEVATIONS ON WALKS & BUILDINGS

GRANADA HILLS SWIMMING POOL AND BATHHOUSE
DEPARTMENT OF RECREATION AND PARKS
CITY OF LOS ANGELES

12" 2" FRAME PAINT BLACK
3/4" WATERPROOF PLYWOOD PAINT WHITE
ALL LETTERS BLACK

DENVER MARKWITH, JR. ARCHITECT | CONTRACTOR'S NAME
RAYMOND L. SMULLINS - ENGINEER | CONTRACTOR'S ADDRESS
6456 YORK BOULEVARD
LOS ANGELES - CALIFORNIA

CONSTRUCTION SIGN - 3/4" = 1'-0"
ATTACH TO CONSTRUCTION FENCE WHERE DIRECTED

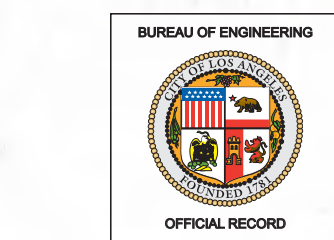

C. P. P. 1-6-71
John H. P. 1-6-71
M. K. Miller
Super G. L.
P. L. L. 1-6-71

DRAWING INDEX	
NO.	TITLE
A-1	PLOT PLAN
A-2	GENERAL FLOOR PLAN
A-3	ROOF PLANS & DETAILS - BATH HOUSE ENTRANCE WALKS & DETAILS
A-4	EXTERIOR ELEVATIONS, DETAILS - BATH HOUSE - SPECTATORS' SHELTER
A-5	SCHEDULES - TOILET & SHOWER ROOM DETAILS
A-6	INTERIOR DETAILS - CENTRAL AREA
A-7	POOL EQUIPMENT BUILDING
A-8	PARTITION, DOOR & WINDOW DETAILS
A-9	POOL DECK PLAN & DETAILS
A-10	POOL DECK DETAILS, BICYCLE RACK
S-1	FOUNDATION PLAN & DETAILS
S-2	STRUCTURAL WALL ELEVATIONS & SECTIONS & DETAILS
S-3	BATH HOUSE ROOF FRAMING PLAN & DETAILS
S-4	EQUIPMENT BLDG., SPECTATORS' SHELTER - ROOF FRAMING PLAN, DETAILS
P-1	PLUMBING PLOT PLAN, GENERAL NOTES, LEGEND
P-2	PLUMBING BATHHOUSE PLANS & DETAILS
P-3	PLUMBING POOL EQUIPMENT BLDG. PLANS & DETAILS
P-4	PLUMBING SWIMMING POOL PLANS & DETAILS
E-1	ELECTRICAL PLOT PLAN & SCHEDULES
E-2	ELECTRICAL POWER & LIGHTING PLAN
L-1	EXISTING WATER LINES, SITE PREPARATION PLAN
L-2	IRRIGATION & SPRINKLER SYSTEM PLAN
L-3	PLANTING PLAN
DA	DEDUCTIVE ALTERNATES

BUTTRISS, McCLELLAN & MARKWITH INC.
DENVER MARKWITH JR. ARCHITECT
RAYMOND L. SMULLINS ENGINEER
6456 YORK BOULEVARD
LOS ANGELES 42 CLINTON 4-1331

SWIMMING POOL & BATH HOUSE for
GRANADA HILLS RECREATION CENTER
16730 CHATSWORTH STREET, LOS ANGELES
DEPARTMENT OF RECREATION & PARKS
LOS ANGELES, CALIFORNIA

TIME PLOT PLAN -
SITE PLAN -

REVISIONS	
BID SET - 1/29/73	

DATE PRINTED	
DRAWN	DATE
CHECK	DATE
JOB	4259
SHEET	

A-1

90% CONSTRUCTION DOCUMENTS
PROJECT ISSUE DATE: 1/11/19

CITY OF LOS ANGELES

DEPARTMENT OF PUBLIC WORKS

BUREAU OF ENGINEERING

VERTICAL CONTROL:	WORK ORDER NO.
HORIZONTAL CONTROL:	#E170517
SHEET TITLE: AS-BUILT A-1	PLAN FILE NO.
PROJECT: GRANADA HILLS POOL AND BATHHOUSE REPLACEMENT PROJECT	#308
ADDRESS: 16730 CHATSWORTH STREET GRANADA HILLS, CA 91344	DRAWING NO.
	A0.01
	SHEET 0 SHEETS



GARY LEE MOORE, PE, ENV SP		CITY ENGINEER
ARCHITECTURAL DIVISION		DATE:
ARCHITECT/ENGINEER: JOHN SPARANO	LIC. NO.: LICENSE	1/11/19
DESIGNED BY: Designer		1/11/19
DRAWN BY: Author		1/11/19
CHECKED BY: Checker		1/11/19
APPROVED BY: Approver		1/11/19

ENGINEERING	INDEX NO.
CITY OF LOS ANGELES	RP-300118
NO.	DATE
REVISION DESCRIPTION	