


POOL EQUIPMENT BUILDING ROOF PLAN
1/8" = 1'-0"

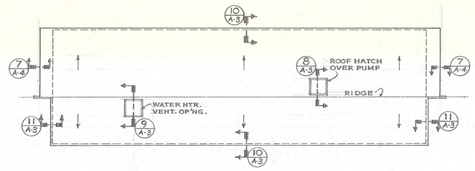


COMPOSITION ROOFING
2 LAYERS 15# ASBESTOS FINISHING FELT - SOLID MOPPINGS BETWEEN & OVER BASE FELTS - 80# MINERAL SURFACED CAP SHEET - ASBESTOS - UNIFORM FINISH APPEARANCE THRUOUT - NO EXPOSED BLACK SURFACES - SEE SPECS.

BATH HOUSE ROOF PLAN • 1/8" = 1'-0"




SPECTATORS' SHELTER ROOF PLAN • 1/8" = 1'-0"

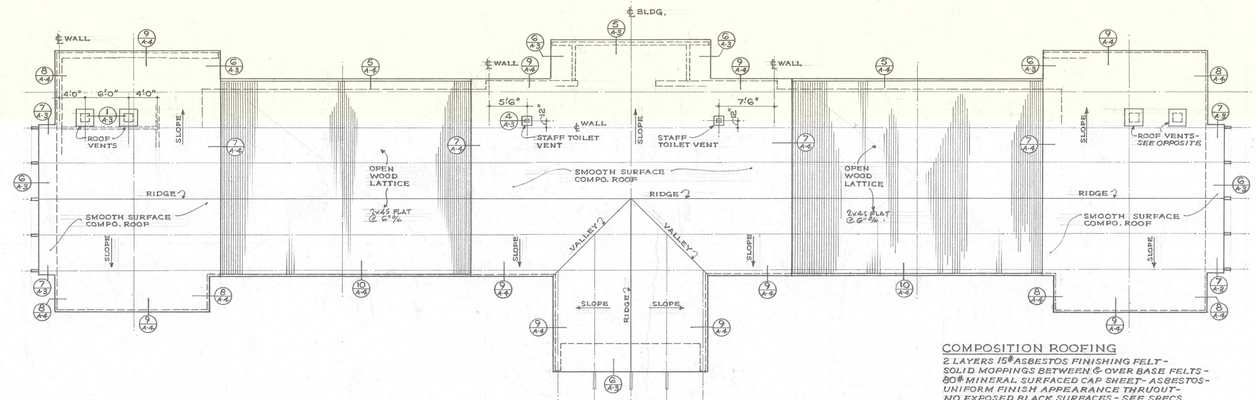


BATH HOUSE ENTRANCE WALKS & DETAILS
1/8" = 1'-0"
~~REFER TO SHT. A-2 FOR EXPLANATION OF GRADES SHOWN HERE.~~
THIS WORK TO BE DESIGNED UNDER THIS CONTRACT TO FIT THE SITE

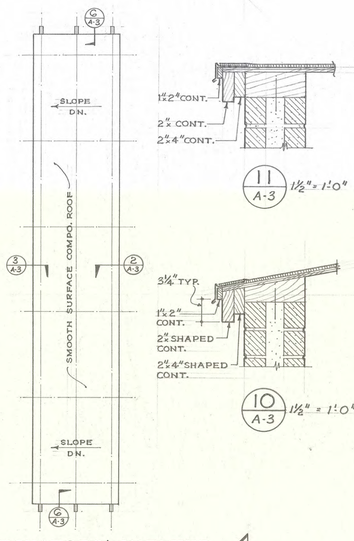


1 A-3 UTILITY RM. VENT
1½" = 1'-0"

NOTE • "WESTERN DURAGLAS" ROOF VENTILATORS OR SIMILAR LOW SILHOUETTE TYPE VENTILATOR WITH EQUAL CAPACITY MAY BE SUBMITTED FOR "BERMUDA-CAP" VENTILATORS

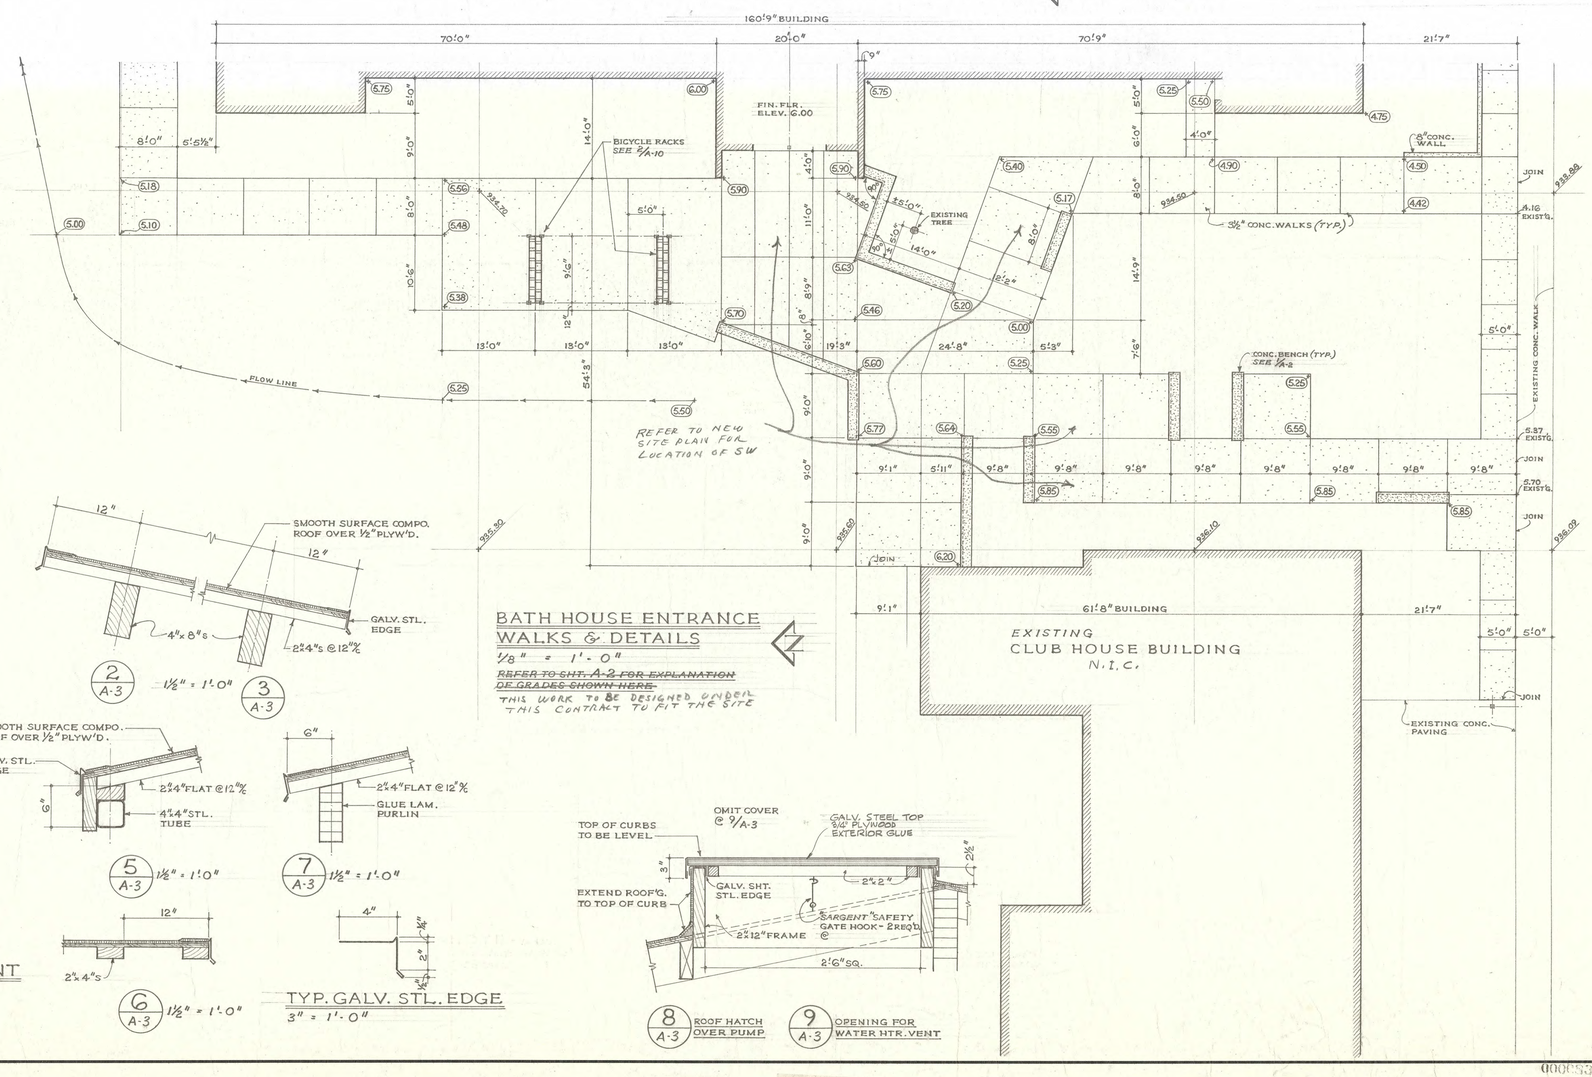


4 A-3 STAFF TOILET VENT
1½" = 1'-0"

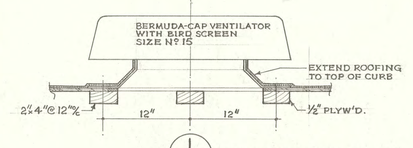


2 A-3 1½" = 1'-0" 3 A-3

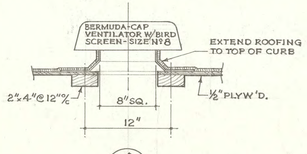


5 A-3 1½" = 1'-0" 7 A-3 1½" = 1'-0"




6 A-3 1½" = 1'-0"




TYP. GALV. STL. EDGE
3" = 1'-0"




8 A-3 ROOF HATCH OVER PUMP
9 A-3 OPENING FOR WATER HTR. VENT

REVISIONS
BID SET - 1/29/73

BUTTRESS, McCLELLAN & MARKWITH INC.
DENVER MARKWITH, ARCHITECT
RAYMOND L. SHULLINS, ENGINEER
6456 YORK BOULEVARD
LOS ANGELES 42 CLINTON 4-4351

SWIMMING POOL & BATH HOUSE for GRANADA HILLS RECREATION CENTER
16730 CHATSWORTH STREET · LOS ANGELES.
DEPARTMENT OF RECREATION & PARKS
LOS ANGELES, CALIFORNIA

TITLE ROOF PLANS & DETAILS.

DATE PRINTED
DRAWN JBT DATE 6-26-70
CHECK DATE 12/21/70
JOB 4259
SHEET A-3

"AS-BUILT" DRAWING FOR REFERENCE ONLY (NOT TO SCALE)

GENERAL NOTES: 1. NOT TO SCALE 2. DIMENSIONS TO BE VERIFIED IN FIELD

308 A 5

BUREAU OF ENGINEERING
OFFICIAL RECORD

BUREAU OF ENGINEERING
ENGINEERING
CITY OF LOS ANGELES

| NO. | REVISION DESCRIPTION | DATE | BY |
|---|---|---|---|

BUILDING NO. -
INDEX NO. RP-300118

LICENSED ARCHITECT GARY P. SPARANO 12211 EXP. 1-31-19 STATE OF CALIFORNIA

DEPARTMENT OF PUBLIC WORKS


GARY LEE MOORE, PE, ENV SP
ARCHITECT/ENGINEER: JOHN SPARANO LIC. NO.: LICENSE
DESIGNED BY: Designer
DRAWN BY: Author
CHECKED BY: Checker
APPROVED BY: Approver

CITY OF LOS ANGELES
VERTICAL CONTROL:
HORIZONTAL CONTROL:
SHEET TITLE: AS-BUILT A-3
PROJECT: GRANADA HILLS POOL AND BATHHOUSE REPLACEMENT PROJECT
ADDRESS: 16730 CHATSWORTH STREET GRANADA HILLS, CA 91344

90% CONSTRUCTION DOCUMENTS
PROJECT ISSUE DATE: 1/11/19

WORK ORDER NO. #E170517
PLAN FILE NO. #308
DRAWING NO. A0.03
SHEET OF SHEETS

PLOTTED:1/13/2019 11:57:02 PM

THE CITY OF LOS ANGELES OR ITS OFFICERS OR AGENTS SHALL NOT BE RESPONSIBLE FOR THE ACCURACY OR COMPLETENESS OF ELECTRONIC COPIES OF THIS PLAN SHEET.

TTLB TEMPLATE REVISION DATE: 02/2013
SHEET ISSUE DATE: 10/07/18
FILE PATH: BIM 360://Granada Hills Pool Renovation/A_Granada-Hills_2017.rvt
REVISION DATES (DESIGN STAGE ONLY)