


"AS-BUILT" DRAWING FOR REFERENCE ONLY (NOT TO SCALE)
GENERAL NOTES: 1. NOT TO SCALE 2. DIMENSIONS TO BE VERIFIED IN FIELD

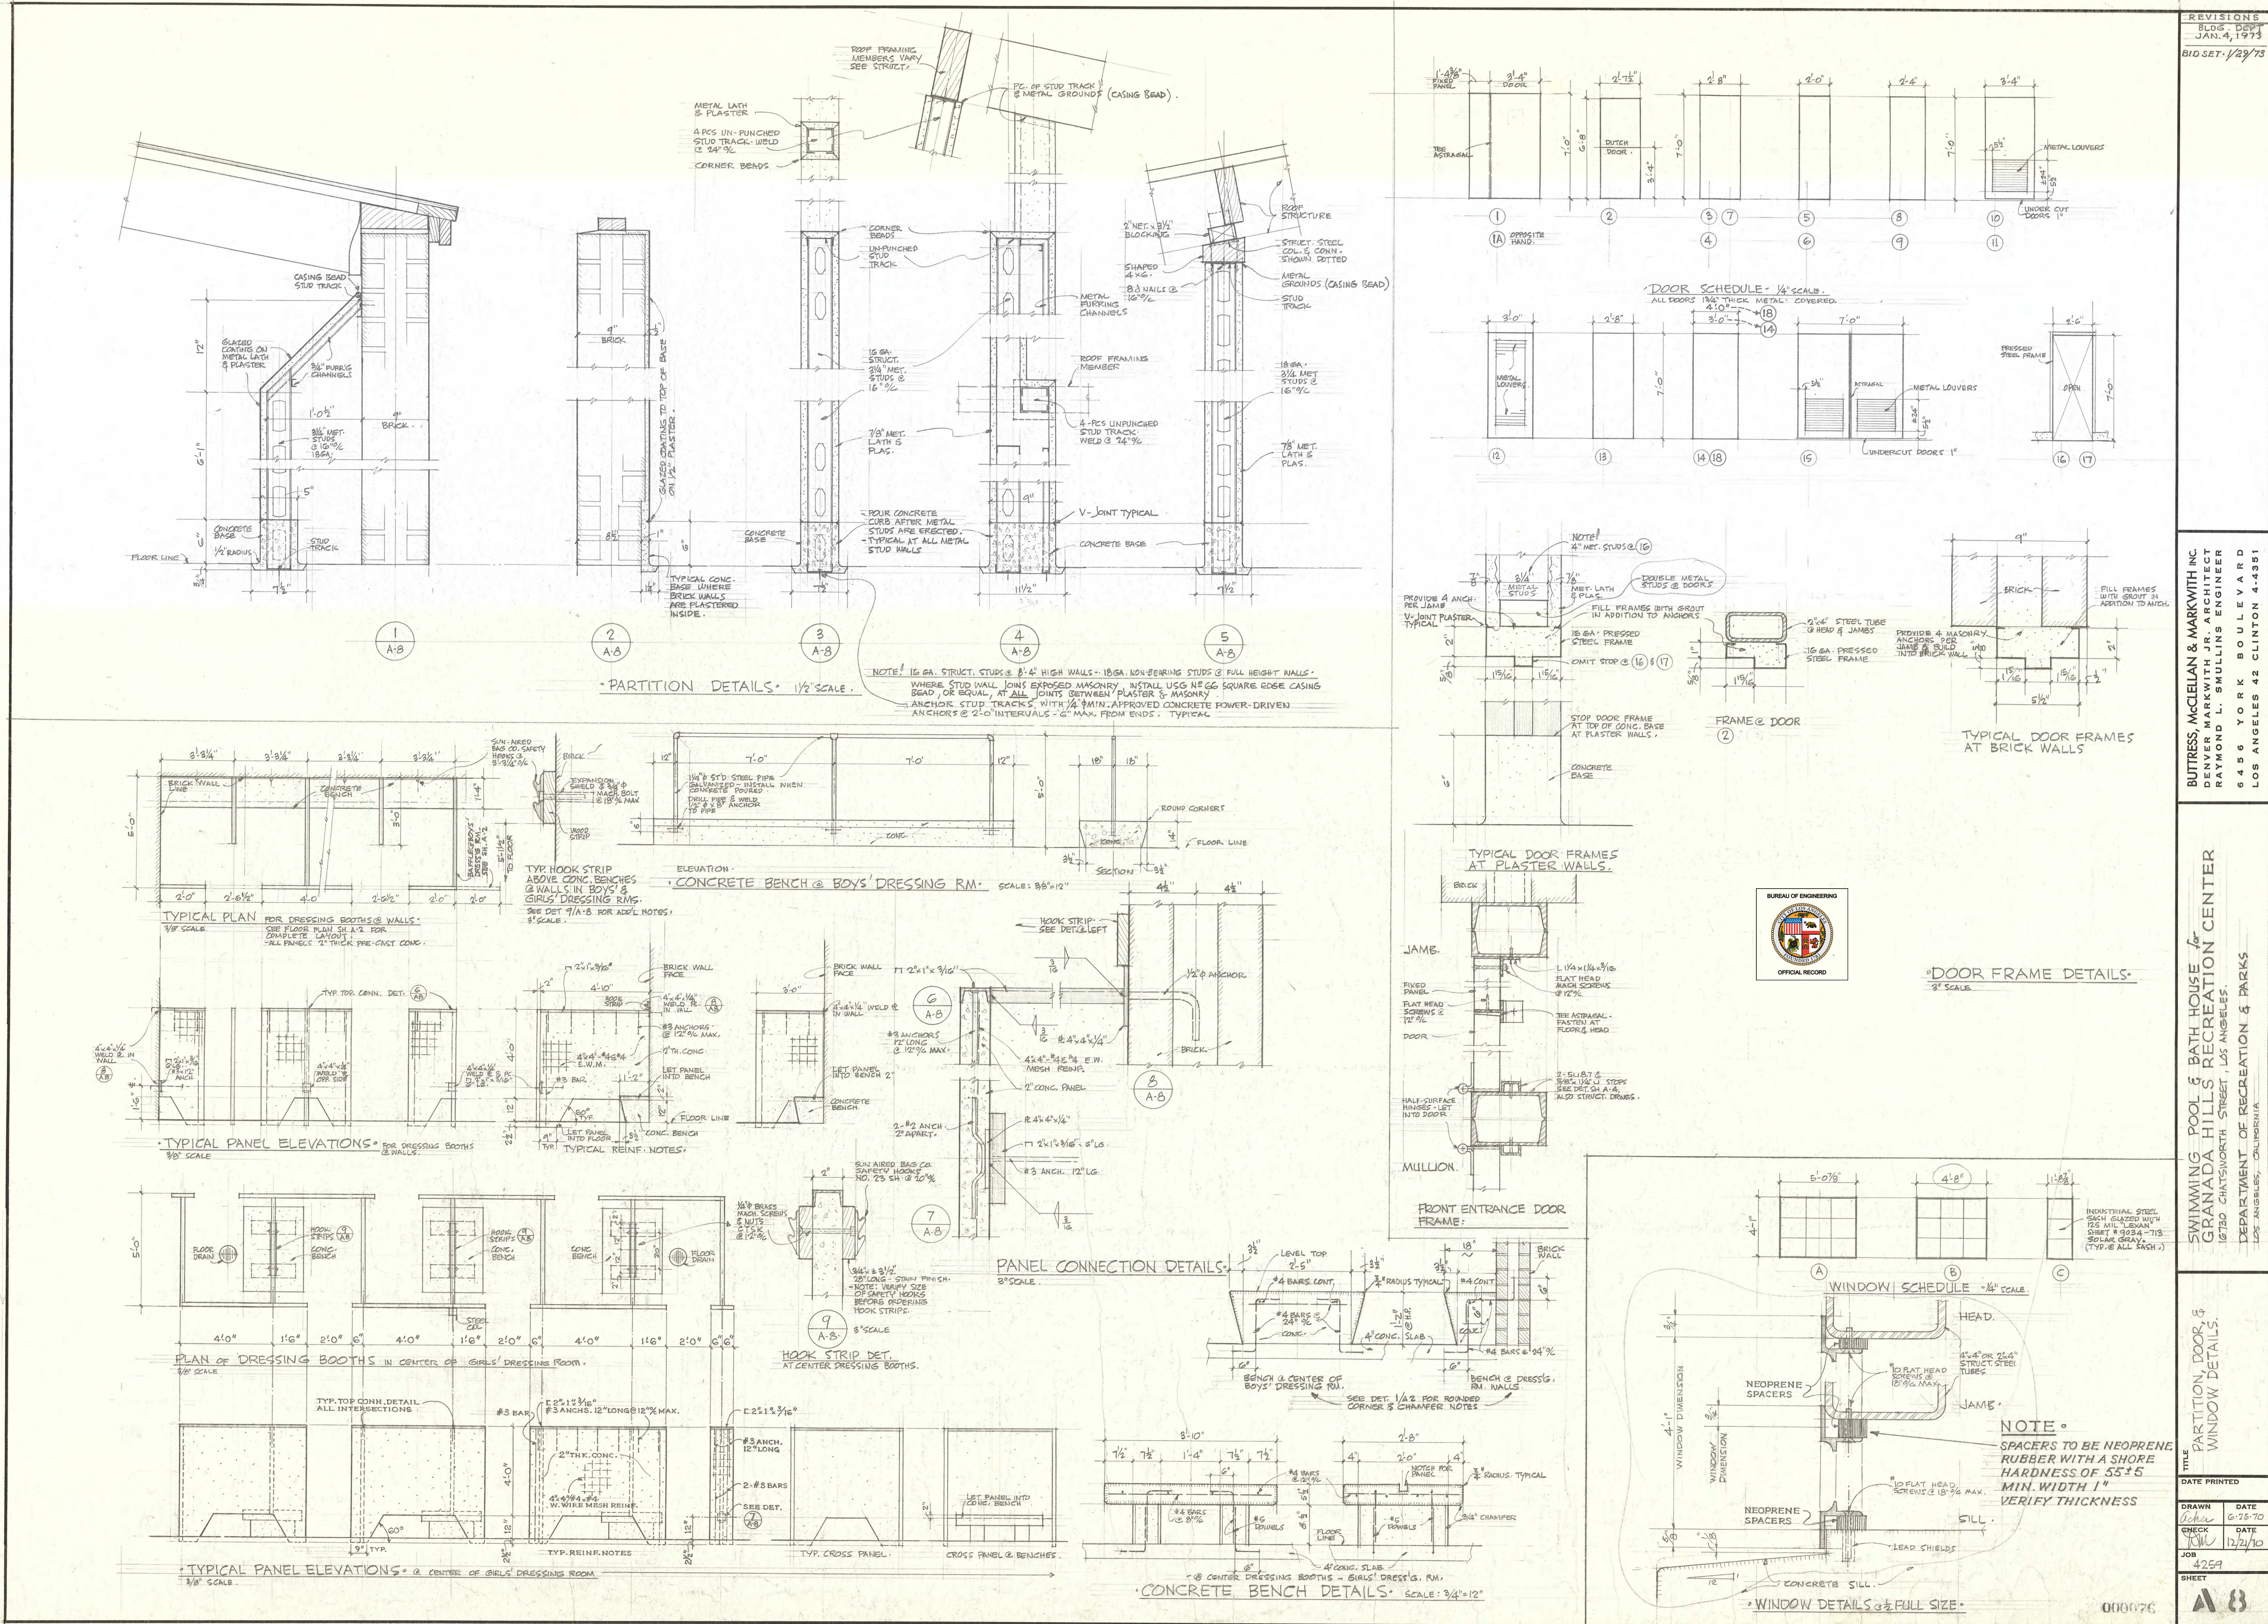

REVISIONS
BLOS. DES.
JAN. 4, 1973
BIO SET-1/29/73

RAYMOND L. SMULLINS ENGINEER
6436 YORK BOULEVARD
LOS ANGELES 42 CLINTON 4-4351

SWIMMING POOL & BATH HOUSE for
GRANADA HILLS RECREATION CENTER
16730 CHATSWORTH STREET, LOS ANGELES.
DEPARTMENT OF RECREATION & PARKS
LOS ANGELES, CALIFORNIA

TITLE
PARTITION, DOOR, &
WINDOW DETAILS.

DATE PRINTED
DRAWN
CHECK
JOB
SHEET

90% CONSTRUCTION DOCUMENTS
PROJECT ISSUE DATE: 1/11/19

CITY OF LOS ANGELES

DEPARTMENT OF PUBLIC WORKS

BUREAU OF ENGINEERING

VERTICAL CONTROL:
HORIZONTAL CONTROL:

WORK ORDER NO.

SHEET TITLE: AS-BUILT A-8

PROJECT:

ADDRESS:

CHECKED BY:

DESIGNED BY:

ARCHITECT/ENGINEER:

CITY ENGINEER:

DATE:













PLAN FILE NO.
#308

DRAWING NO.
A0.08

SHEET 0 SHEETS

GRANADA HILLS POOL AND BATHHOUSE
REPLACEMENT PROJECT
16730 CHATSWORTH STREET
GRANADA HILLS, CA 91344

DESIGNED BY: Designer
AUTHOR
CHECKED BY: Checker
APPROVED BY: Approver

ARCHITECT/ENGINEER: JOHN SPARANO LIC. NO.: LICENSE
DATE: 1/11/19

DATE: 1/11/19

INDEX NO. RP-300118

ENGINEERING
CITY OF LOS ANGELES